Space Plan

Floor 01

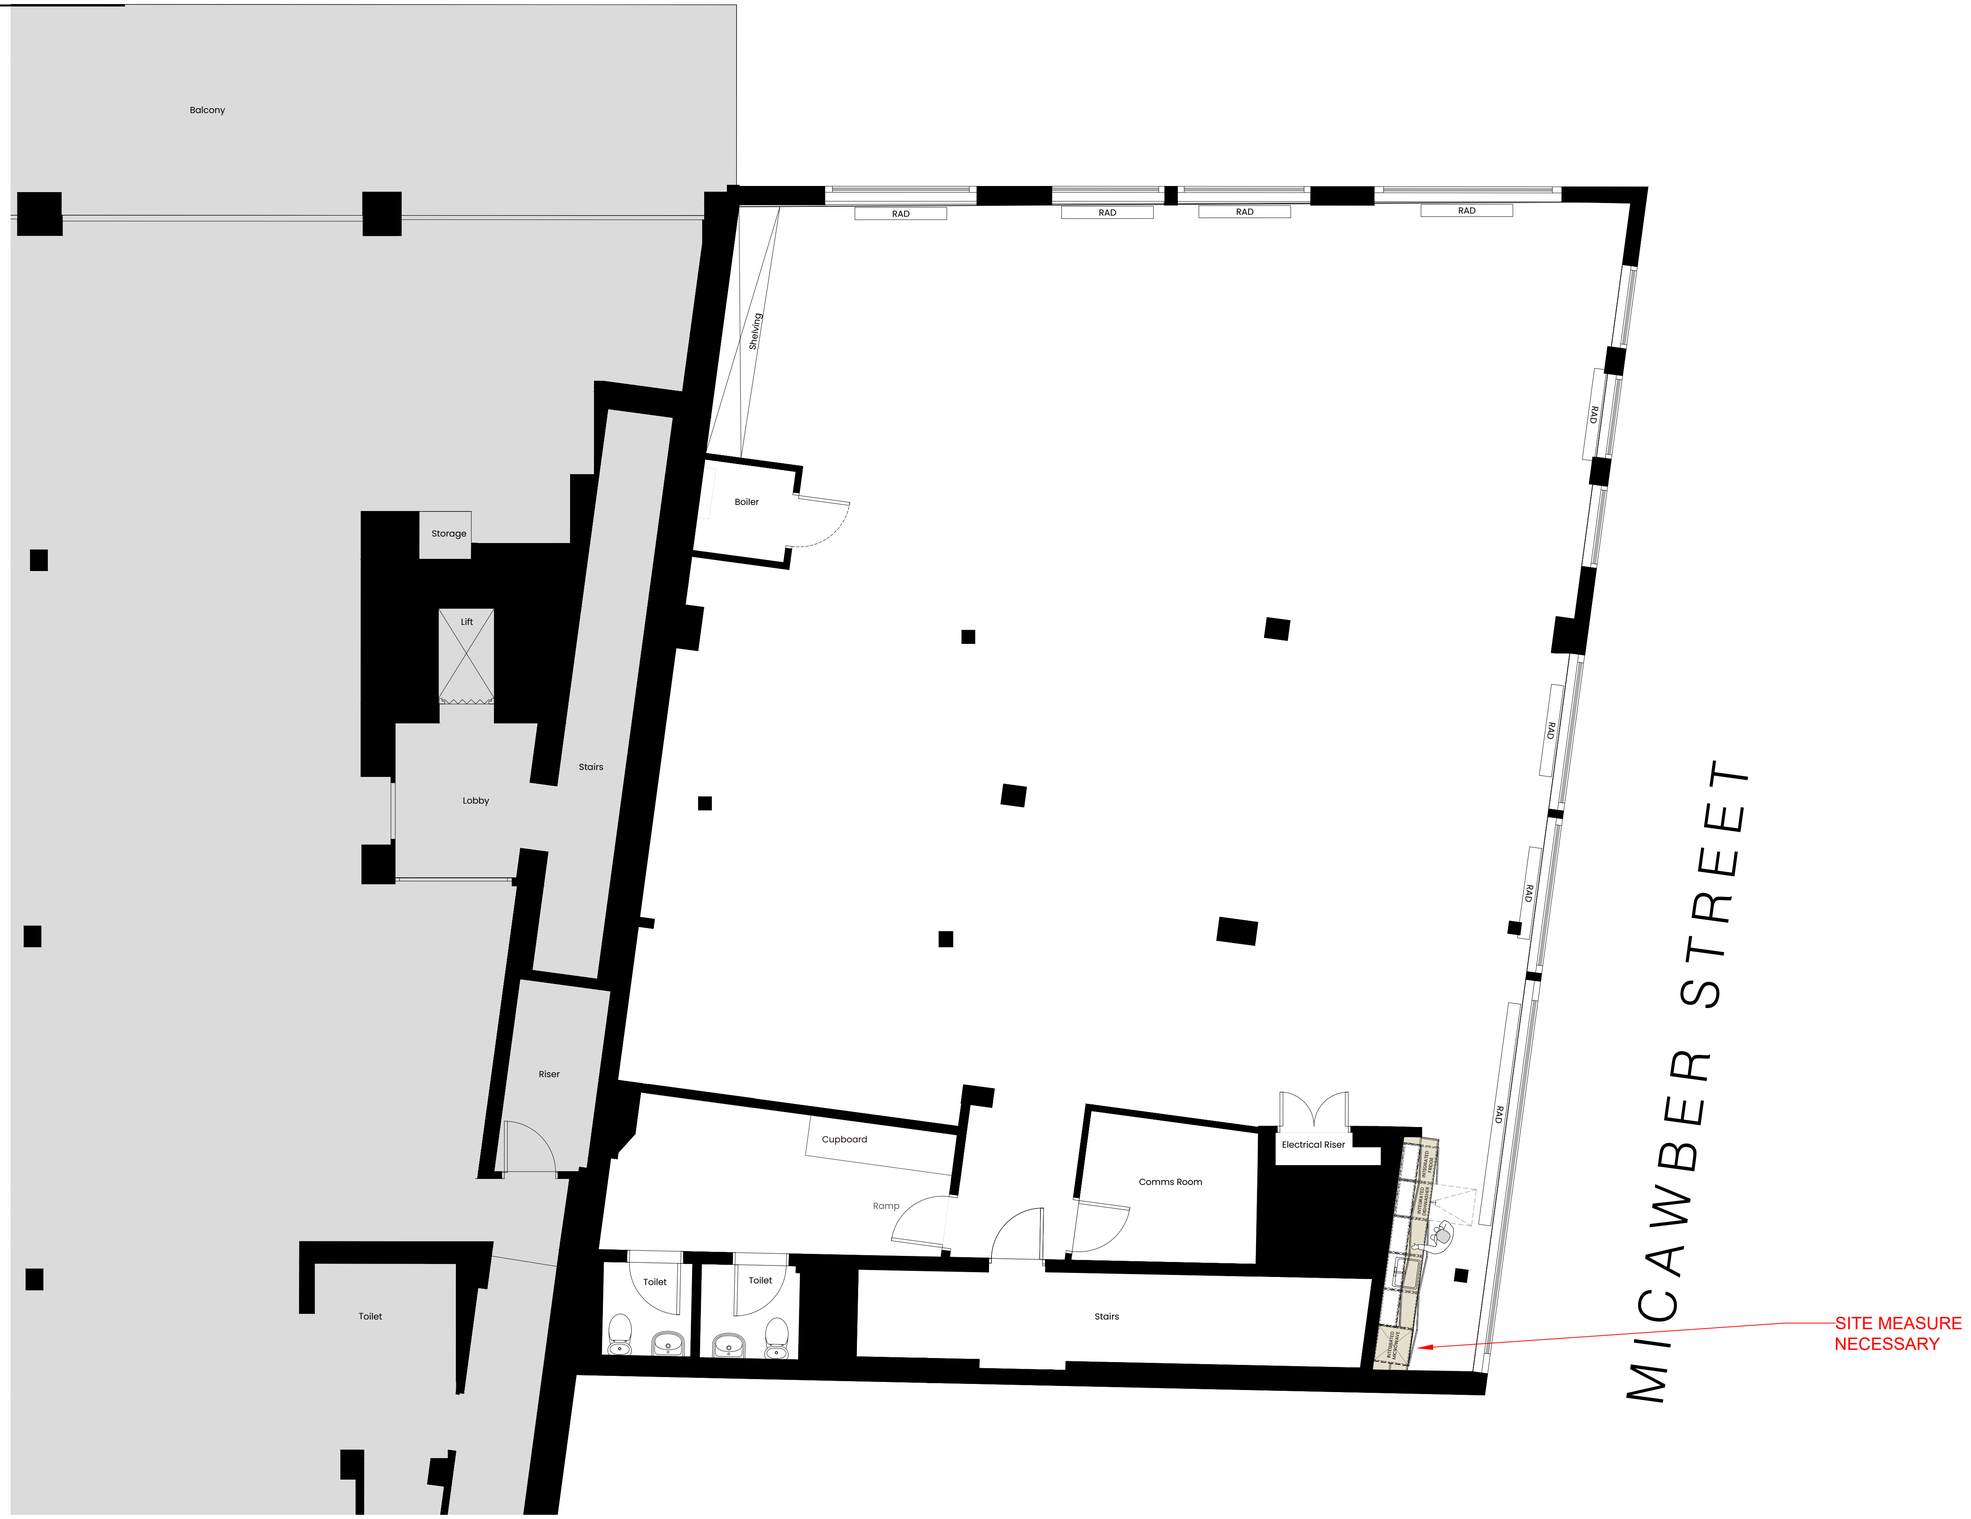

0m 1m 2m 3m 4m 5m 6m 7m 8m

MARIS INTERIORS

Accommodation Schedule

1	Tea-Point
1	Office
1	Meeting Room (6)
1	Meeting Room (10)
1	Collaboration desk (6)
-	--
-	--
-	--
-	--
-	--
-	--
-	--
22	Fixed desks
30	Total Working Positions

REV	DESCRIPTION	BY	DATE
D	ISSUED FOR CONSTRUCTION	EM/BJ	26/05/2023
C	Cupboard removed	EM/BJ	18/05/2023
B	Drawing updated	EM/BJ	10/05/2023
A	Drawing updated	EM/BJ	20/03/2023
-	Drawing first produced	EM/BJ	08/03/023

DRAWING STATUS
CONSTRUCTION

Micawber Street Properties Ltd

Address
15D Micawber Street
London
-

Project Number	Ref	Floor	Detail	Rev
32395	01	01	GA	C

Drawing Title
Floor 01
Space Plan (Design)

Produced by	Scale	Date Created
EM/BJ	1:50@A1	08/03/023

MARIS INTERIORS
The Harlequin Building
65 Southwark Street
London SE1 0HR
T 020 7902 1866
E hello@maris.co.uk
W maris.co.uk

Floor 01

© MARIS INTERIORS LLP Property & Copyright
Use of drawings is not permitted nor can they be copied, duplicated or distributed without the consent of the LLP.

All designs are the sole property of MARIS INTERIORS LLP, and may not be used, transferred, or disclosed to a third party without the express permission of MARIS INTERIORS LLP. Electronic copies of this drawing are supplied for convenience only. No dimensions or other information should be used from the electronic copy. Do not scale from this drawing. Figured dimensions only are to be used 'For Construction' and any scaling of the drawing will be at the Contractor's risk. Contractor to verify all dimensions, levels, and components on-site. Any discrepancies shall be addressed in writing to this office for clarification prior to the commencement of the work, otherwise the Contractor shall bear full responsibility for any associated cost. Any claims for variations or extras shall be submitted to this office for assessment prior to approval of any such variation or extra. This drawing is to be read in conjunction with all other Contract documentation. This drawing must be signed otherwise it will be invalid. Building parameters taken from as built drawings provided. Check survey undertaken only, subject to statutory approval. All dimensions shown are in millimetres unless otherwise shown.